



three inches = one foot
 one and one-half inches = one foot
 one inch = one foot
 three-quarters inch = one foot
 one-half inch = equals one foot
 three-eighths inch = one foot
 one-quarter equals one foot
 one-eighth inch = one foot

- NOTES:**
1. CONTRACTOR TO FIELD VERIFY ALL EXISTING ELEVATIONS.
 2. COORDINATE ALL SITE WORK, GRADING, ASPHALT PATCHING WITH PROJECTS UNDER SEPARATE CONTRACT.
 3. SEE ARCHITECTURAL PLANS FOR LANDSCAPE PLAN AND SPECIFICATIONS.

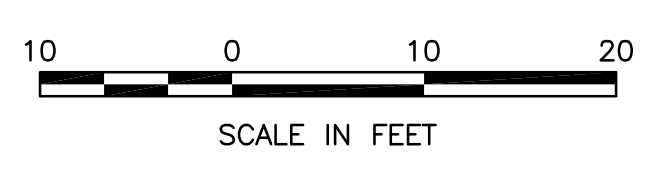

BUILDING IS FULLY SPRINKLERED

RECORD DRAWING	1/20/11
AMENDMENT	10/12/09
Revisions	Date



HDR
HDR Architecture Inc.

601 Union Street | Suite 100 | Seattle, WA 98101 | 206.466.4700

Approved For:	Name	Initials	Date
Construction <input type="checkbox"/>	Director		
Submittal <input type="checkbox"/>	Assoc. Dir.		
	Ch. of Staff		
	Ch. of Eng.		

Drawing Title
CIVIL SITE AND GRADING PLAN

Approved: Area Project Manager

Project Title
B100 EMERGENCY EXPANSION AT SEATTLE DIVISION OF VA PUGET SOUND HEALTH CARE SYSTEM

Building Number
BUILDING B100

Location
 VA PUGET SOUND HEALTH CARE SYSTEM - SEATTLE
 1660 SOUTH COLUMBIAN WAY SEATTLE, WA 98108

Date
06/22/2009

Solicitation No.
VA-260-09-IB-0472

DRAWING NO.
CG-101/R

Dwg. 7 of 122



CONSTRUCTION MANAGEMENT

Department of Veterans Affairs